



SUITE 1200

AS-BUILT

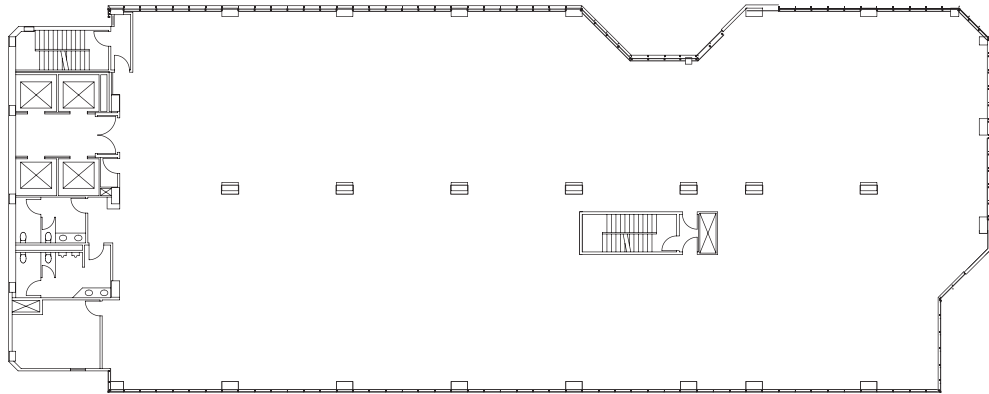

CONCEPTUAL LAYOUT

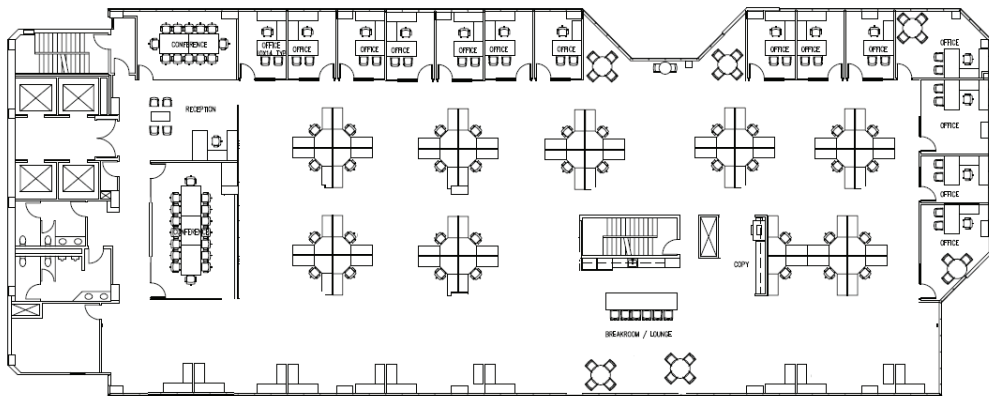

SUITE	1200
RSF	15,949
VIEW	Full Floor
STATUS	Vacant



For additional information:

Richard Gonor
858.410.1243
richard.gonor@am.jll.com

Bess Wakeman
858.410.1245
bess.wakeman@am.jll.com

Brandt Riedman
858.410.1247
brandt.riedman@am.jll.com

Owned & professionally managed by:

