


# 2 COLUMBIA PLACE



## SUITE 1200

1230 COLUMBIA STREET  
SAN DIEGO CA 92101  
DOWNTOWN

### CONCEPTUAL LAYOUT

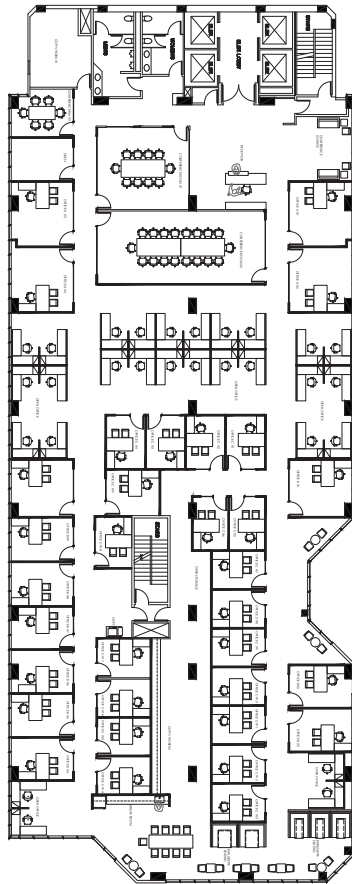

### AS-BUILT

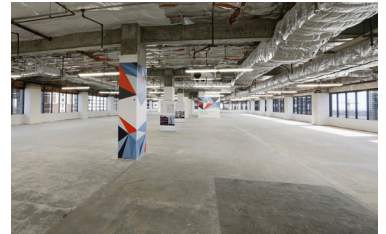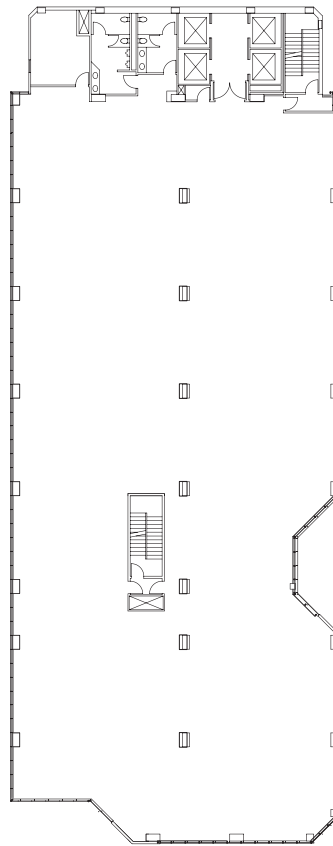

N

W

E

S

For additional information:

STEVEN M. BRUCE  
858.875.3605  
steve.bruce@ngkf.com  
CA RE Lic. #01455744

CHRISTOPHER P. HIGH  
858.875.3604  
chris.high@ngkf.com  
CA RE Lic. # 01734544

CONOR EVANS  
858.875.3607  
conor.evans@ngkf.com  
CA RE Lic. # 01963596

SUITE	1200
RSF	15,882
STATUS	Vacant
DESCRIPTION	Creative Potential Full Floor Opportunity Opening Ceiling + Bay Views

Owned & professionally managed by:

