


2 COLUMBIA PLACE



1230 COLUMBIA STREET
SAN DIEGO CA 92101
DOWNTOWN

SUITE 1200

CONCEPTUAL LAYOUT

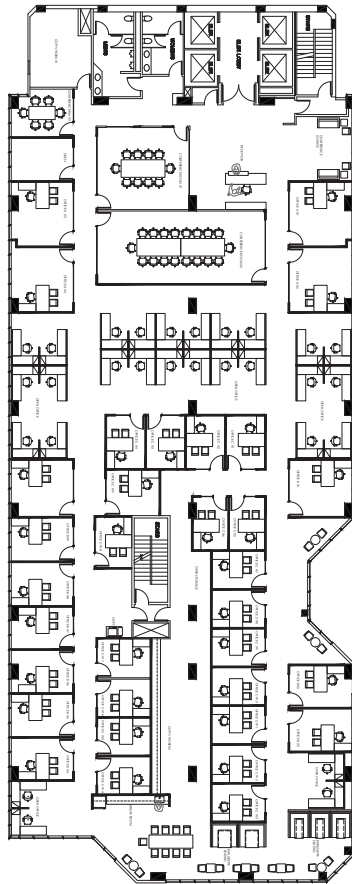

AS-BUILT

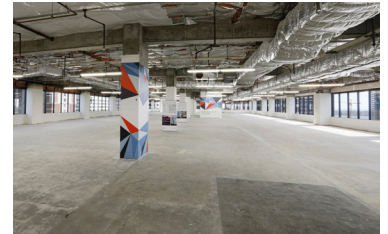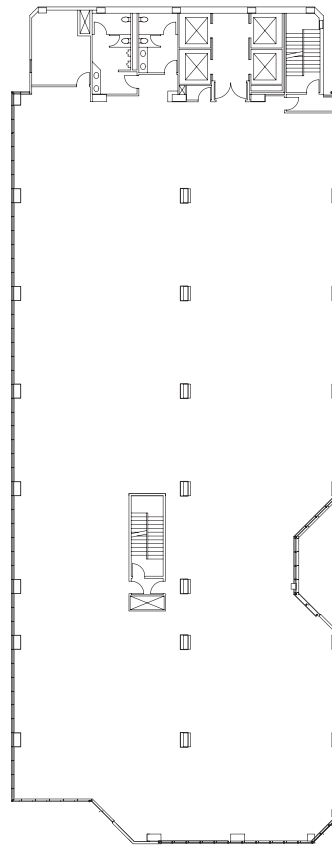

N

W

E

S

For additional information:

STEVEN M. BRUCE
858.875.3605
steve.bruce@ngkf.com
CA RE Lic. #01455744

CHRISTOPHER P. HIGH
858.875.3604
chris.high@ngkf.com
CA RE Lic. # 01734544

CONOR EVANS
858.875.3607
conor.evans@ngkf.com
CA RE Lic. # 01963596

SUITE	1200
RSF	15,882
STATUS	Vacant
DESCRIPTION	Creative Potential Full Floor Opportunity Opening Ceiling + Bay Views

Creative Potential
Full Floor Opportunity
Opening Ceiling + Bay Views

Owned & professionally managed by:



NEWMARK